
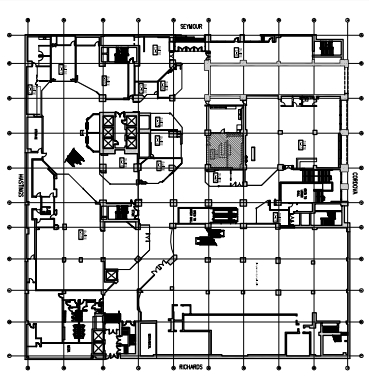


SUITE U-4/5

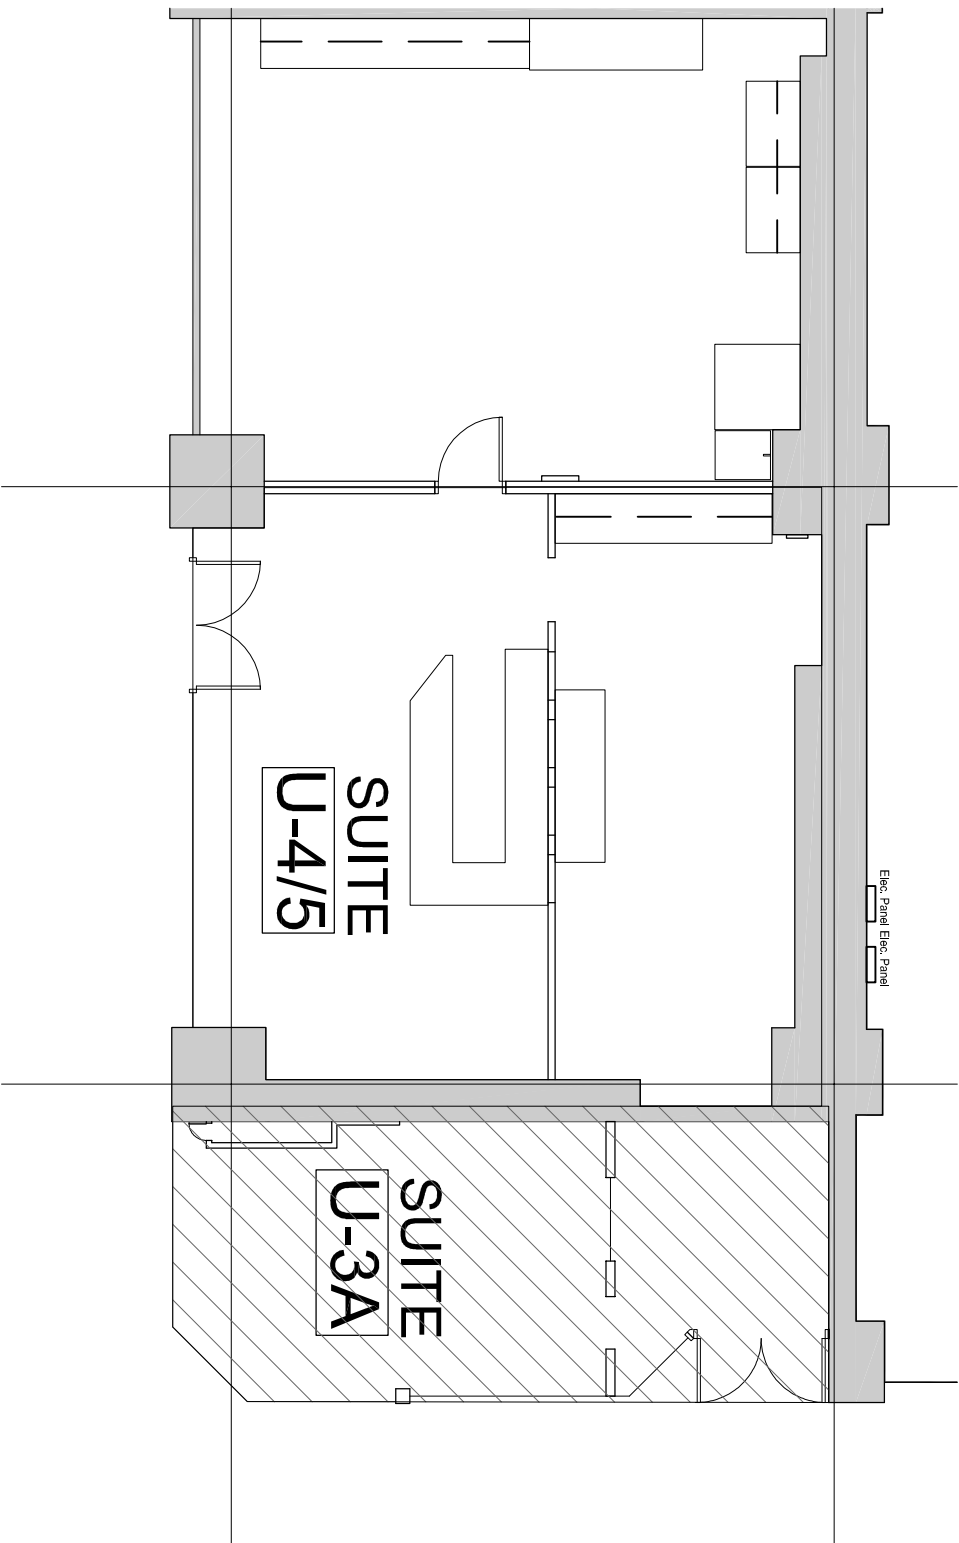

Key Plan

Scale: NOT TO SCALE


Copyright reserved. This drawing is and at all times remains the exclusive property of Harbour Centre Complex Limited and may not be used or duplicated without our written consent. This drawing is for reference purposes only. All measurements should be verified on site.

Asbuilt Drawings:

Suite U-4/5

Spencer Building
555 West Hastings Street, Vancouver, Bc

Date: January 1, 2019
Rentable Area: 1,546 SF

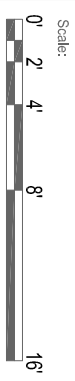

Managed By:



Harbour Centre
Complex Ltd.

Suite 2000, Harbour Centre
555 West Hastings Street
Vancouver, BC V6B 4W6
P: 604.684.7304
F: 604.684.7875